



NOTES

- ALL DIMENSIONS ARE IN MILLIMETRES UNLESS NOTED OTHERWISE.
- FOR TYPICAL DETAILS OF PAVEMENT MATERIALS REFER TO MP-09-110 FOR FLAG STONE PAVING AND MP-09-111 FOR SETT PAVING (INCLUDING ALL OTHER PAVEMENTS.)
- FOR DETAILS REFER TO PAVEMENT SPECIFICATION, MP-09-DES-SP FOR THE FOLLOWING:
  - CONCRETE COLOUR TO PAVEMENTS - CI.3.2.3
  - BOX IN-SITU KERBS TO PAVEMENTS - CI.5.11.6 AND JOINT LOCATION CI.5.11.8
  - CONCRETE FINISH, SAND BLAST - CI.5.9.3
  - BEDDING TO STONE KERB - CI.5.11.4 AND CI.5.11.5

**AS-BUILT**

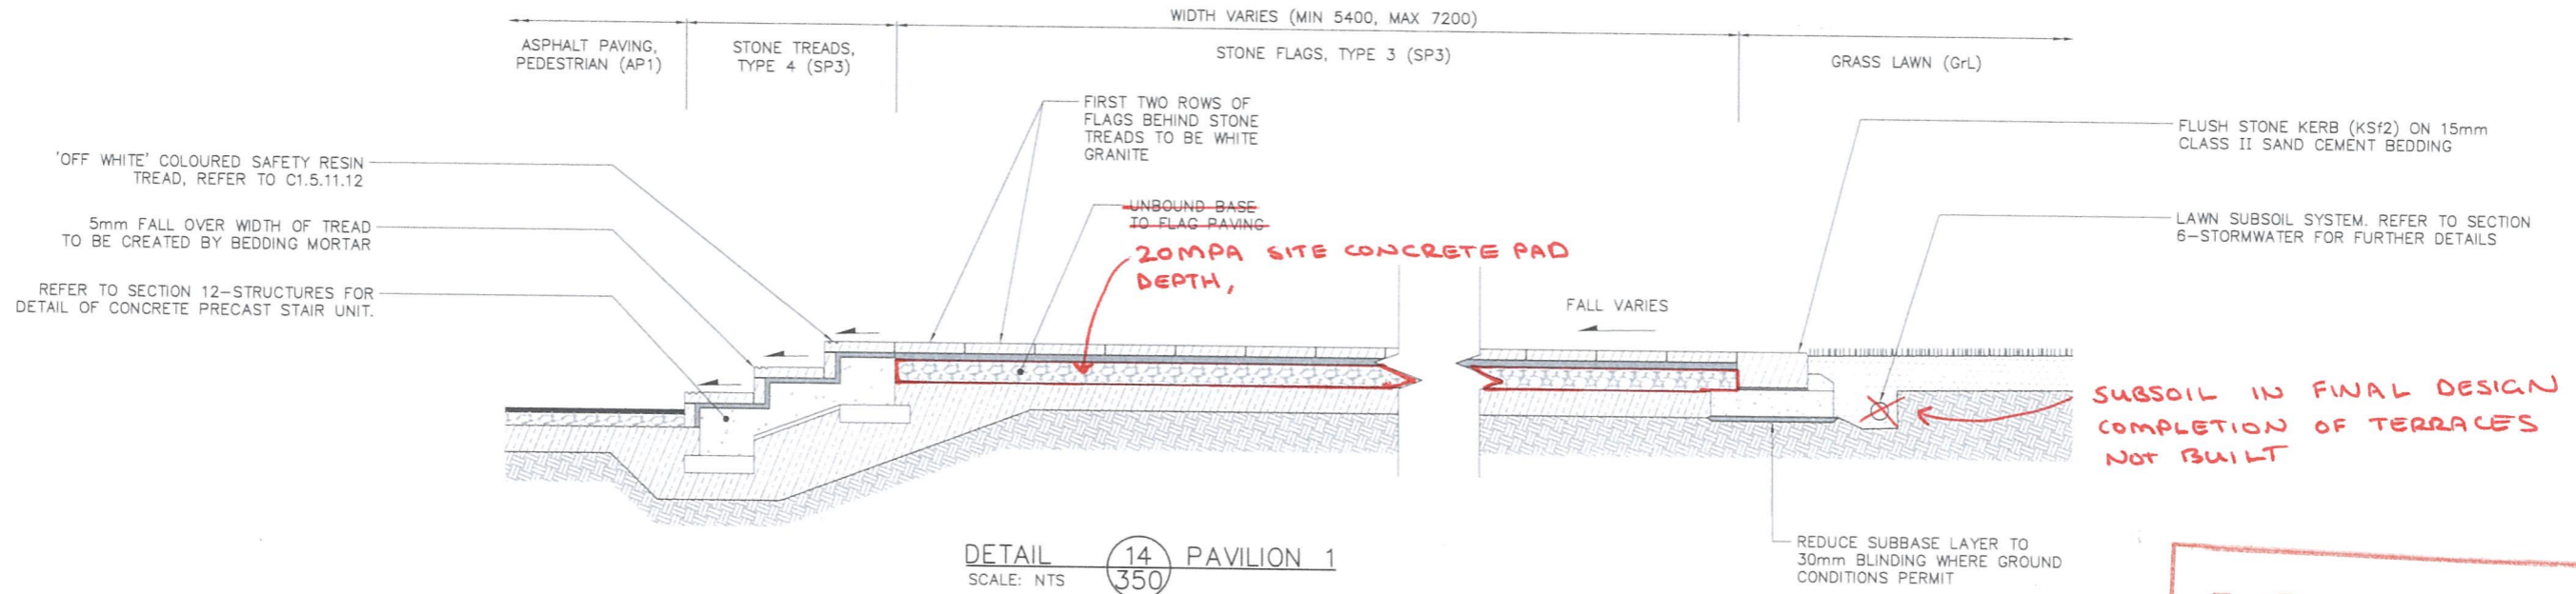

**AS-BUILT**

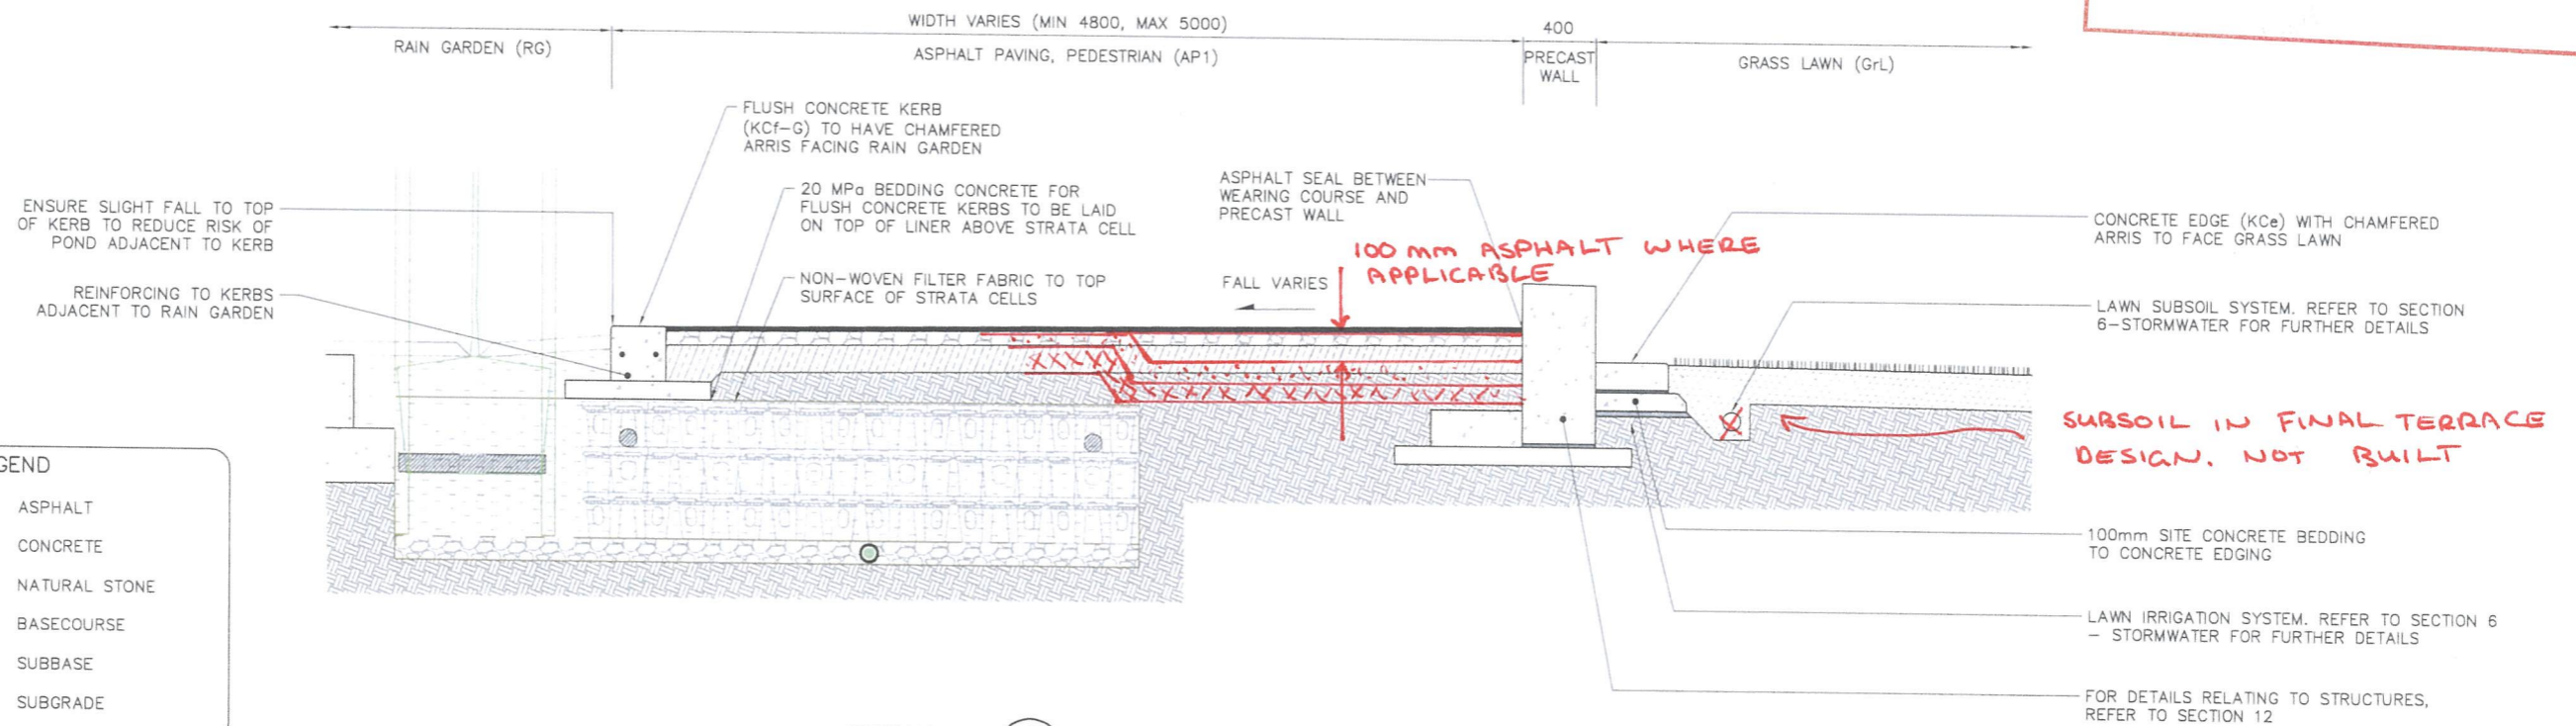

|                   |                  |     |     |     |  |   |   |   |
|-------------------|------------------|-----|-----|-----|--|---|---|---|
| <p>2 AS BUILT</p> |                  |     |     |     | <p>Tab MP-09-361</p> <p>Scales NTS</p> <p>Original Size A1</p> | <p>NZ TRANSPORT AGENCY</p> <p>Memorial Park Alliance</p>                  | <p>SH1 WELLINGTON INNER CITY IMPROVEMENTS</p> <p>MEMORIAL PARK - 09 PAVEMENTS</p> <p>TYPICAL SECTIONS</p> <p>AREA 3 - SHEET 1</p> | <p>Approved</p> <p>Status FOR CONSTRUCTION</p> <p>Drawing Number MP-09-361</p> <p>Revision 2</p>  |
| 1                 | FOR CONSTRUCTION | RJP | RJP | DMT | 06/06/14   | <p>Document Controller Check: MKS</p> <p>Date: 17/06/15</p> <p>6/6/14</p> | <p>This drawing is not to be used for construction purposes unless signed approved and issued For Construction</p>                | <p>DO NOT SCALE FROM THIS DRAWING - Document copyright of Memorial Park Alliance and its project consultants and may only be used for its intended purpose.</p> |