


NOTES

1. ALL DIMENSIONS ARE IN MILLIMETRES UNLESS NOTED OTHERWISE.
2. FOR TYPICAL DETAILS OF PAVEMENT MATERIALS REFER TO MP-09-110 FOR FLAG STONE PAVING AND MP-09-111 FOR SETT PAVING (INCLUDING ALL OTHER PAVEMENTS.)
3. FOR DETAILS REFER TO PAVEMENT SPECIFICATION, MP-09-DES-SP FOR THE FOLLOWING:
  - CONCRETE COLOUR TO PAVEMENTS - CI.3.2.3
  - BOX IN-SITU KERBS TO PAVEMENTS - CI.5.11.6 AND JOINT LOCATION CI.5.11.8
  - CONCRETE FINISH, SAND BLAST - CI.5.9.3
  - BEDDING TO STONE KERB - CI.5.11.4 AND CI.5.11.5

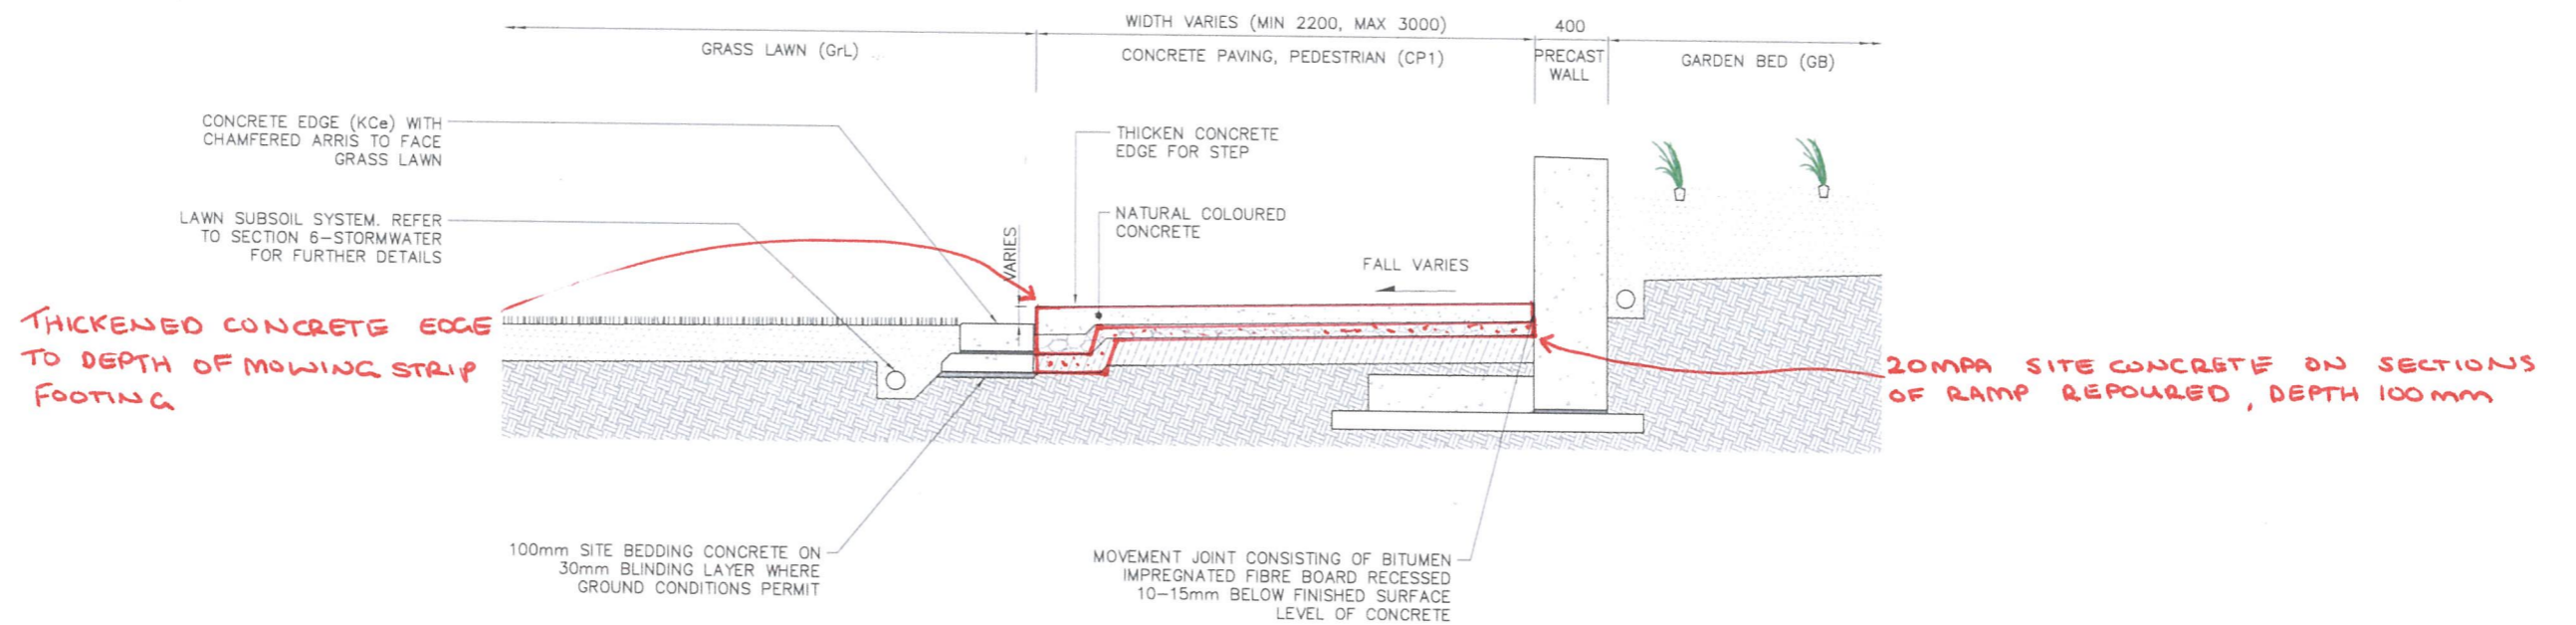

DETAIL 16 WESTERN PEDESTRIAN FOOTWAY CONCRETE PATH  
SCALE: NTS 350

LEGEND	
	ASPHALT
	CONCRETE
	NATURAL STONE
	BASECOURSE
	SUBBASE
	SUBGRADE

**AS-BUILT**  
20/4/15 mlyllie.

2 AS BUILT		RJP		RJP		DMT		Approved		Date: 06/06/14		Original Size		A1	
1 FOR CONSTRUCTION		RJP		RJP		DMT		Approved		Date: 17/06/15		Original Size		A1	
Rev		Revision Description		Drawn		Checked		Designed		Design Checked		Approved		Date	

NZ TRANSPORT AGENCY  
WAIKATO

Memorial Park Alliance

Document Controller Check: MKV

Date: 6/6/15

SH1 WELLINGTON INNER CITY IMPROVEMENTS

MEMORIAL PARK - 09 PAVEMENTS  
TYPICAL SECTIONS  
AREA 3 - SHEET 2

Approved

Status: FOR CONSTRUCTION

Drawing Number: MP-09-362

Revision: 2

Z:\CAD 01\WCI\01 CAD\01 Dwg\09 Pavements\MEMORIAL PARK (MP) Dwg\MP-09-361\_363.dwg PRINTED BY: RICHARD\_PENWELL 6-Jun-14 2:48 p.m. DO NOT SCALE FROM THIS DRAWING - Document copyright of Memorial Park Alliance and its project consultants and may only be used for its intended purpose.