


LONG SECTION 1 GAS & STREET LIGHT DUCTS
SCALE 1:125

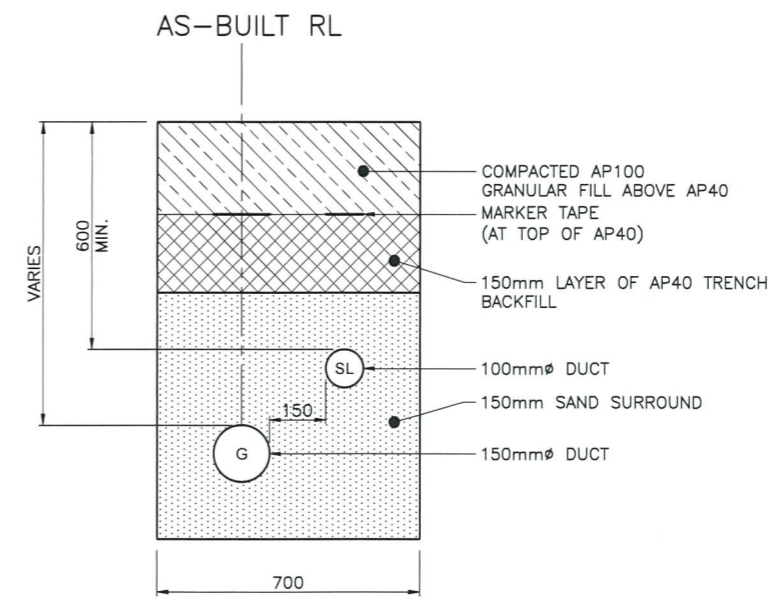

SECTION-TYPICAL TRENCH
SCALE 1:10

AS-BUILT
SIGNED BY CONSTRUCTION TEAM,
ON BEHALF OF MEMORIAL PARK ALLIANCE
[Signature] 3/6/16
SIGNATURE: DATE:



2 AS BUILT		RJP	-	-	-	8/6/16	1: 250 (A3)	 Memorial Park Alliance	MEMORIAL PARK STAGE 2		Approved
1 FOR CONSTRUCTION		SYP	ARAC	PGC	DG	RP	1: 125 (A1)		05-UTILITIES LONG SECTION DRY SERVICES DUCTS		Status AS BUILT
A 100% DETAILED DESIGN FOR REVIEW		VK	ARAC	PGC	EC	RP	12/1/16		Document Controller Check: <i>[Signature]</i> Date: 8/6/16 <small>This drawing is not to be used for construction purposes unless signed approved and issued for construction</small>		Drawing Number MP2-05-101